

D16+	COUNTY	ROUTE	POST MILES TOTAL PROJECT	SHEET No.	TOTAL SHEETS



Atifa Ferouz
REGISTERED CIVIL ENGINEER

April 20, 2018
PLANS APPROVAL DATE

Atifa Ferouz
No. C80402
Exp. 3-31-19
CIVIL
REGISTERED PROFESSIONAL ENGINEER
STATE OF CALIFORNIA

THE STATE OF CALIFORNIA OR ITS OFFICERS OR AGENTS SHALL NOT BE RESPONSIBLE FOR THE ACCURACY OR COMPLETENESS OF SCANNED COPIES OF THIS PLAN SHEET.



CENTERLINES
(2 LANE HIGHWAYS)

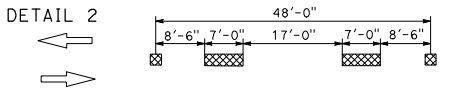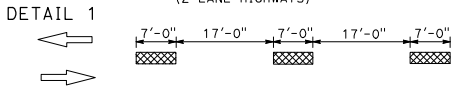

~~DETAIL 3~~ DETAIL 3 DELETED

~~DETAIL 4~~ DETAIL 4 DELETED

LANELINES (Cont)
(MULTILANE HIGHWAYS)

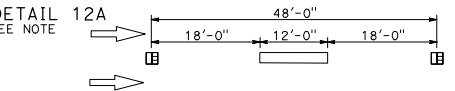
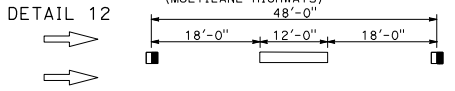


~~DETAIL 13~~ DETAIL 13 DELETED

~~DETAIL 14~~ DETAIL 14 DELETED

~~DETAIL 14A~~ DETAIL 14A DELETED

NO PASSING ZONES-TWO DIRECTION

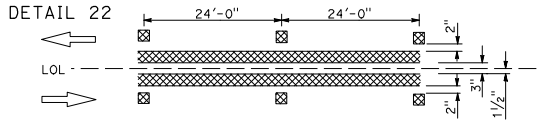
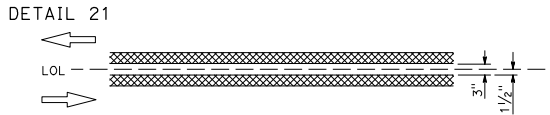


~~DETAIL 23~~ DETAIL 23 DELETED



- LEGEND**
- MARKERS**
- TYPE C RED-CLEAR RETROREFLECTIVE
 - TYPE D TWO-WAY YELLOW RETROREFLECTIVE
 - TYPE G ONE-WAY CLEAR RETROREFLECTIVE
 - TYPE H ONE-WAY YELLOW RETROREFLECTIVE

- LINES**
- 6" WHITE
 - 6" YELLOW

NO PASSING ZONES-ONE DIRECTION


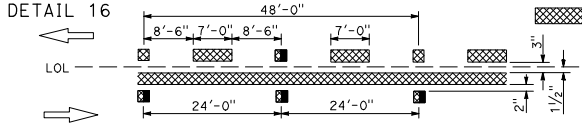
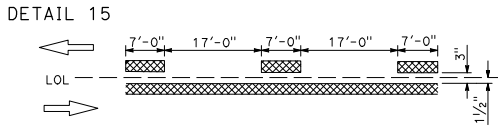


~~DETAIL 17~~ DETAIL 17 DELETED

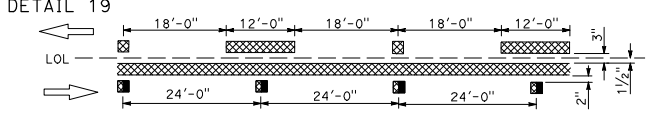
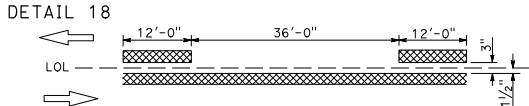


~~DETAIL 20~~ DETAIL 20 DELETED

LANELINES
(MULTILANE HIGHWAYS)

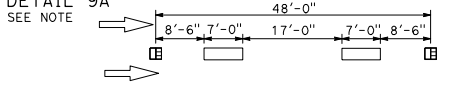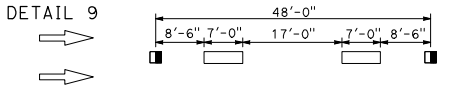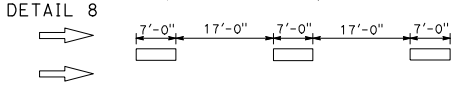

~~DETAIL 10~~ DETAIL 10 DELETED

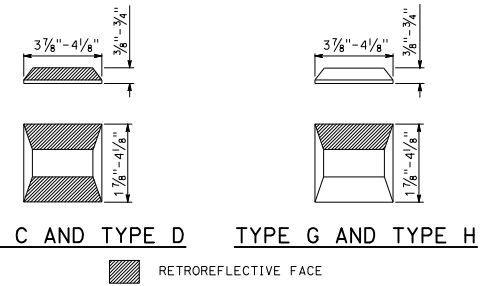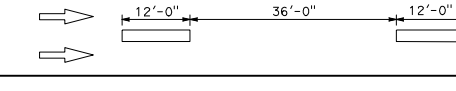

STATE OF CALIFORNIA
DEPARTMENT OF TRANSPORTATION

**PAVEMENT MARKERS
AND TRAFFIC LINES
TYPICAL DETAILS**

NO SCALE

NOTE:
FOR FREEWAY APPLICATION ONLY


RSP A20A DATED APRIL 20, 2018 SUPERSEDES RSP A20A DATED JULY 21, 2017 AND STANDARD PLAN A20A DATED OCTOBER 30, 2015 - PAGE 12 OF THE STANDARD PLANS BOOK DATED 2015.

REVISED STANDARD PLAN RSP A20A


2015 REVISED STANDARD PLAN RSP A20A

LEFT EDGELINES


(DIVIDED HIGHWAYS)

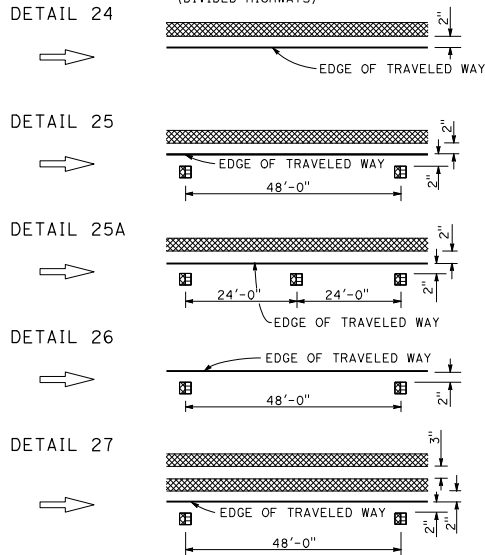


RIGHT EDGELINES

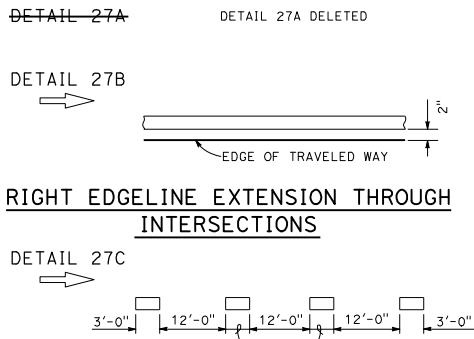

MEDIAN ISLANDS

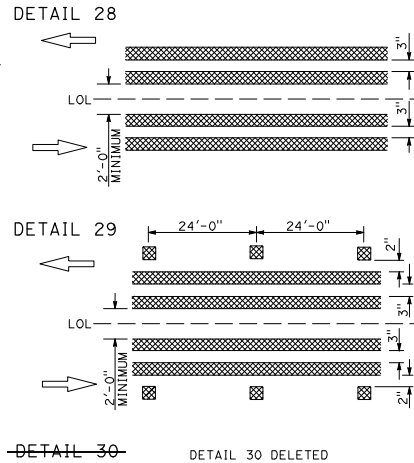


TWO-WAY LEFT TURN LANES

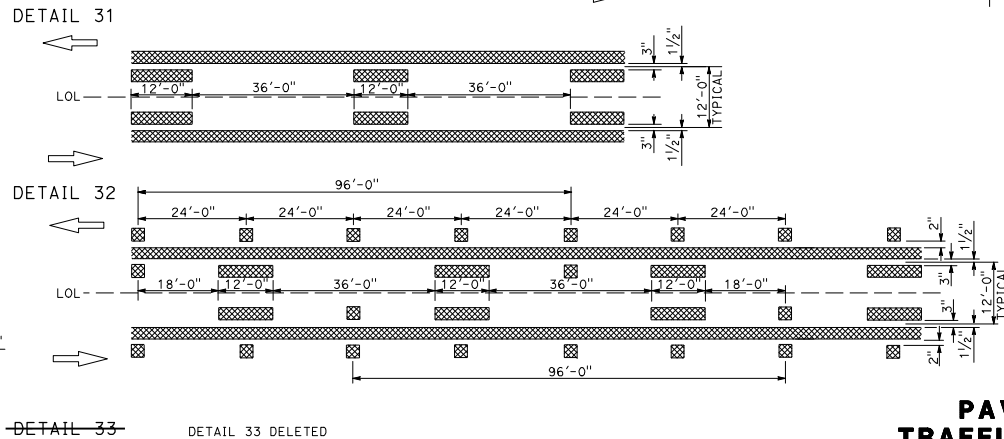


LEGEND

- MARKERS**
- TYPE D TWO-WAY YELLOW RETROREFLECTIVE
 - TYPE H ONE-WAY YELLOW RETROREFLECTIVE
 - TYPE RY RED-YELLOW RETROREFLECTIVE
- LINES**
- 6" WHITE
 - 6" YELLOW

INTERSECTION TREATMENTS

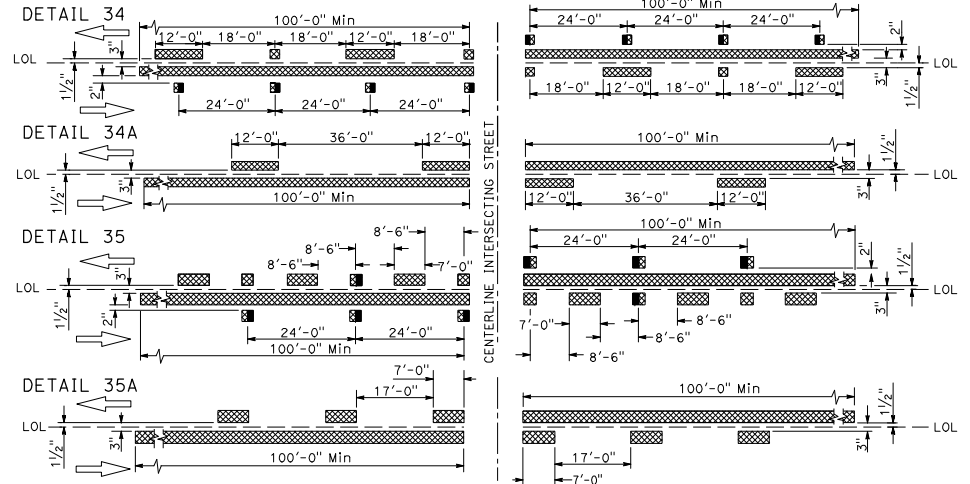

MARKER DETAILS

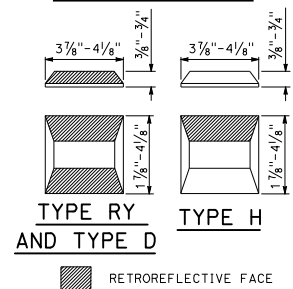

PAVEMENT MARKERS AND TRAFFIC LINES TYPICAL DETAILS

NO SCALE

RSP A20B DATED APRIL 20, 2018 SUPERSEDES RSP A20B DATED JULY 21, 2017 AND STANDARD PLAN A20B DATED OCTOBER 30, 2015 - PAGE 13 OF THE STANDARD PLANS BOOK DATED 2015.

REVISED STANDARD PLAN RSP A20B

D16+	COUNTY	ROUTE	POST MILES TOTAL PROJECT	SHEET NO.	TOTAL SHEETS
------	--------	-------	--------------------------	-----------	--------------

Atifa Ferouz
REGISTERED CIVIL ENGINEER

April 20, 2018
PLANS APPROVAL DATE

Atifa Ferouz
No. C80402
Exp. 3-31-19
CIVIL

THE STATE OF CALIFORNIA OR ITS OFFICERS OR AGENTS SHALL NOT BE RESPONSIBLE FOR THE ACCURACY OR COMPLETENESS OF SCANNED COPIES OF THIS PLAN SHEET.

2015 REVISED STANDARD PLAN RSP A20B

DIST	COUNTY	ROUTE	POST MILES TOTAL PROJECT	SHEET TOTAL SHEETS


Atifa Ferouz
REGISTERED CIVIL ENGINEER

April 20, 2018
PLANS APPROVAL DATE


Atifa Ferouz
No. C80402
Exp. 3-31-19
REGISTERED PROFESSIONAL ENGINEER
CIVIL
STATE OF CALIFORNIA

THE STATE OF CALIFORNIA OR ITS OFFICERS OR AGENTS SHALL NOT BE RESPONSIBLE FOR THE ACCURACY OR COMPLETENESS OF SCANNED COPIES OF THIS PLAN SHEET.


EXIT RAMP NEUTRAL AREA (GORE) TREATMENT

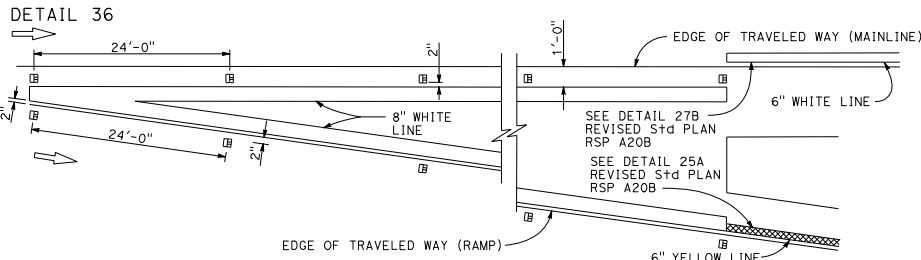

ENTRANCE RAMP NEUTRAL AREA (MERGE) TREATMENT

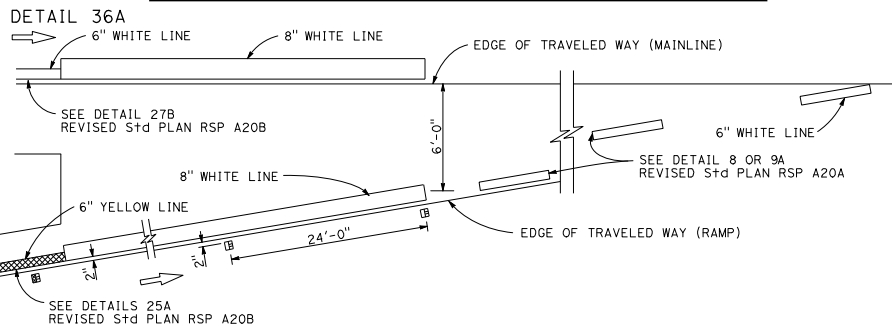

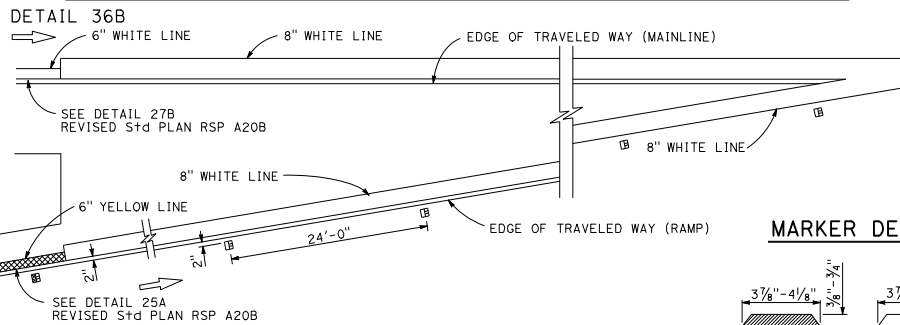


ENTRANCE RAMP NEUTRAL AREA (ACCELERATION LANE) TREATMENT




LEGEND:


MARKERS

-  TYPE C RED-CLEAR RETROREFLECTIVE
-  TYPE G ONE-WAY CLEAR RETROREFLECTIVE
-  TYPE RY RED-YELLOW RETROREFLECTIVE

MARKER DETAILS

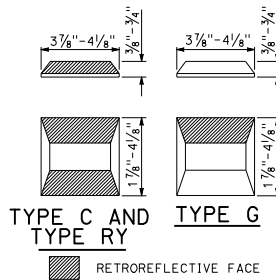


LANE DROP AT EXIT RAMP

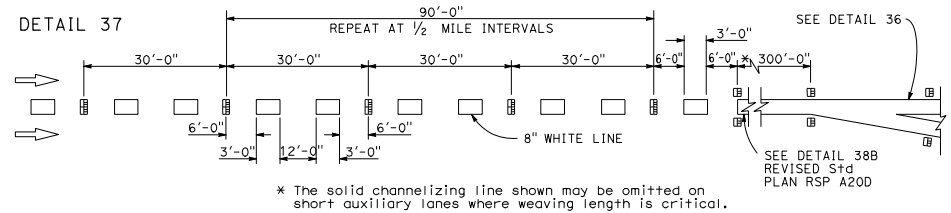

~~DETAIL 37A~~ DETAIL 37A DELETED

LANE DROP AT INTERSECTIONS

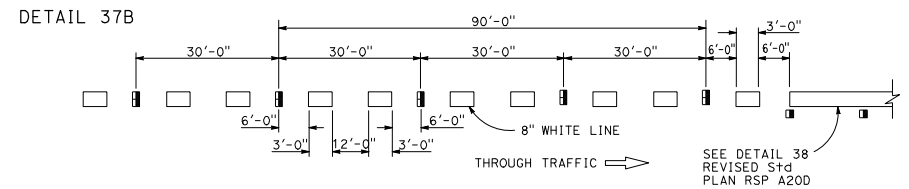

~~DETAIL 37C~~ DETAIL 37C DELETED

STATE OF CALIFORNIA
DEPARTMENT OF TRANSPORTATION

**PAVEMENT MARKERS
AND TRAFFIC LINES
TYPICAL DETAILS**




NO SCALE

RSP A20C DATED APRIL 20, 2018 SUPERSEDES RSP A20C DATED JULY 21, 2017 AND STANDARD PLAN A20C DATED OCTOBER 30, 2015 - PAGE 14 OF THE STANDARD PLANS' BOOK DATED 2015.

REVISED STANDARD PLAN RSP A20C

2015 REVISED STANDARD PLAN RSP A20C

CHANNELIZING LINE

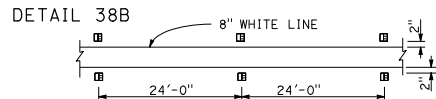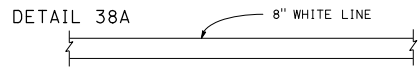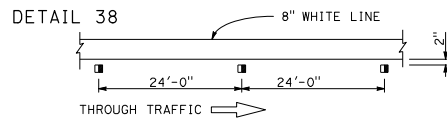


DETAIL 38C DELETED


BIKE LANE LINE




**INTERSECTION LINE
BIKE LANE**

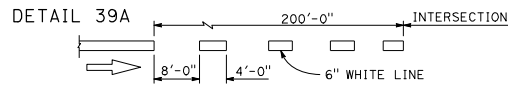

**LANE LINE EXTENSIONS
THROUGH INTERSECTIONS**

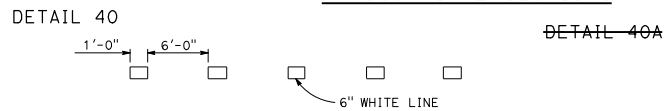

**CENTER LINE EXTENSIONS
THROUGH INTERSECTIONS**


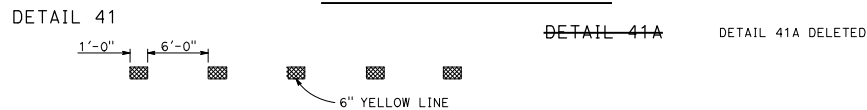


LEGEND

MARKERS

- TYPE C RED-CLEAR RETROREFLECTIVE
- TYPE G ONE-WAY CLEAR RETROREFLECTIVE
- 6" YELLOW LINE


MARKER DETAILS

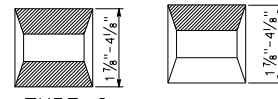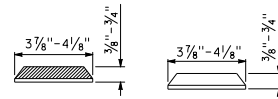

TYPE C

TYPE G

RETROREFLECTIVE FACE




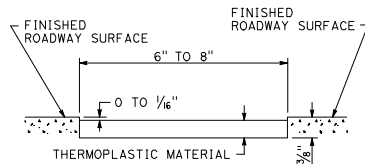


**DETAIL FOR RECESSED
THERMOPLASTIC TRAFFIC STRIPE**


See Notes A and B.

RECESSED THERMOPLASTIC NOTES

- A. See typical traffic line details for pavement marking patterns.
- B. The top of the thermoplastic installed in recessed pavement shall be 0 to 1/16" below the pavement surface.

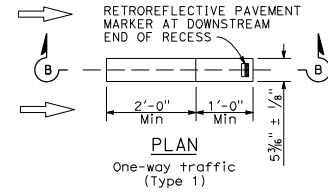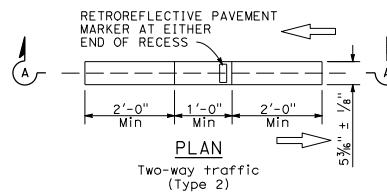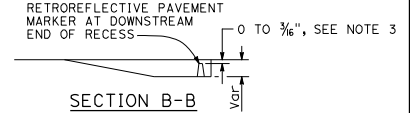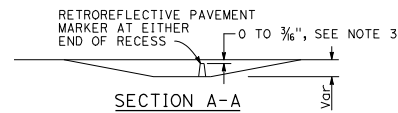

**RECESS DETAIL FOR
RETROREFLECTIVE PAVEMENT MARKER**

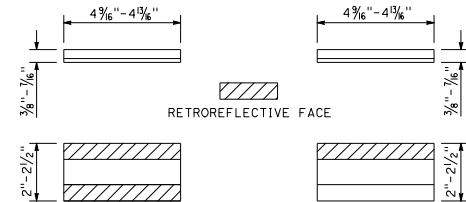

RECESSED MARKER NOTES:

1. See typical traffic line details for marker patterns to be used with recessed pavement markers. Detail 14A requires a Type 2 recess.
2. The retroreflective pavement markers shown for recessed installations are not to be used for non-recessed installations.
3. The top of pavement markers installed in recesses shall be 0 to 3/16" below the pavement surface.

TYPE C AND TYPE D TYPE G AND TYPE H

See Notes 1 and 2.

**RETROREFLECTIVE PAVEMENT MARKER
FOR RECESSED INSTALLATION**

STATE OF CALIFORNIA
DEPARTMENT OF TRANSPORTATION

**PAVEMENT MARKERS
AND TRAFFIC LINES
TYPICAL DETAILS**

NO SCALE

RSP A200 DATED APRIL 20, 2018 SUPERSEDES RSP A200 DATED JULY 21, 2017 AND STANDARD PLAN A200 DATED OCTOBER 30, 2015 - PAGE 15 OF THE STANDARD PLANS BOOK DATED 2015.

REVISED STANDARD PLAN RSP A200

2015 REVISED STANDARD PLAN RSP A200

DIST	COUNTY	ROUTE	POST MILES TOTAL PROJECT	SHEET NO.	TOTAL SHEETS

Atifa Ferouz
REGISTERED CIVIL ENGINEER

April 20, 2018
PLANS APPROVAL DATE

Atifa Ferouz
No. C80402
Exp. 3-31-19
CIVIL

THE STATE OF CALIFORNIA OR ITS OFFICERS
OR AGENTS SHALL NOT BE RESPONSIBLE FOR
THE ACCURACY OR COMPLETENESS OF SCANNED
COPIES OF THIS PLAN SHEET.